LEGEND

SYMBOLS:

- IRRIGATION CONTROL VALVE
- FIRE HYDRANT
- WATER VALVE
- WATER METER
- POWER POLE W/ LIGHT
- POWER POLE
- POWER POLE ANCHOR
- SOLAR LIGHTS
- CUSTOM STREET LIGHT
- JUNCTION BOX
- SANITARY SEWER MANHOLE
- DHA SURVEY CONTROL
- SURFACE MONUMENT
- MONUMENT IN CASE
- SHRUB
- DECIDUOUS
- CONIFER
- SIGN
- MAILBOX
- STORM DRAIN CATCH BASIN(TYPE II)
- STORM DRAIN CATCH BASIN(TYPE I)
- GAS VALVE
- GAS METER
- WATER VAULT
- POST INDICATOR VALVE
- TELEPHONE MANHOLE
- TELEPHONE VAULT
- RADIO ANTENNA

ABBREVIATIONS:

CONC/C	CONCRETE
PA	PLANTED AREA
PVC	POLYVINYL CHLORIDE PIPE
(A)	APPROXIMATE
CMP	CORRUGATED METAL PIPE
PRD	PER RECORD DRAWING
CO	CLEAN-OUT
ICV	IRRIGATION CONTROL VALVE
RD	ROOF DRAIN
TR	TOP OF RAILROAD RAIL ELEVATION

TREES:

C	CEDAR
M	MAPLE
F	FIR
P	PINE
DEC	DECIDUOUS
WAL	WALNUT
CY	CHERRY
ORN	ORNAMENTAL
CW	COTTONWOOD
A	ALDER

LINETYPES:

- EDGE OF ASPHALT
- PLAT LOT LINE
- STREET R/W LINE
- STREET R/W CENTERLINE
- FENCING
- UNDERGROUND STORM LINE
- UNDERGROUND SEWER LINE
- UNDERGROUND WATER LINE
- UNDERGROUND POWER LINE
- OVERHEAD POWER LINE
- UNDERGROUND FIBER OPTIC LINE
- UNDERGROUND TELEPHONE LINE
- ROCKERY

SURVEYING AND MAPPING BY:
DUANE HARTMAN & ASSOCIATES, INC.
Surveyors
16928 WOODINVILLE-REDMOND ROAD, B-107
WOODINVILLE, WASHINGTON 98072
(425) 483-5355
FAX (425) 483-4650
DHA JOB No. 11-2827/22-3257

CALL 2 DAYS BEFORE YOU DIG 1-800-424-5555

SCALE IN FEET: 20' 10' 0 20' 40'

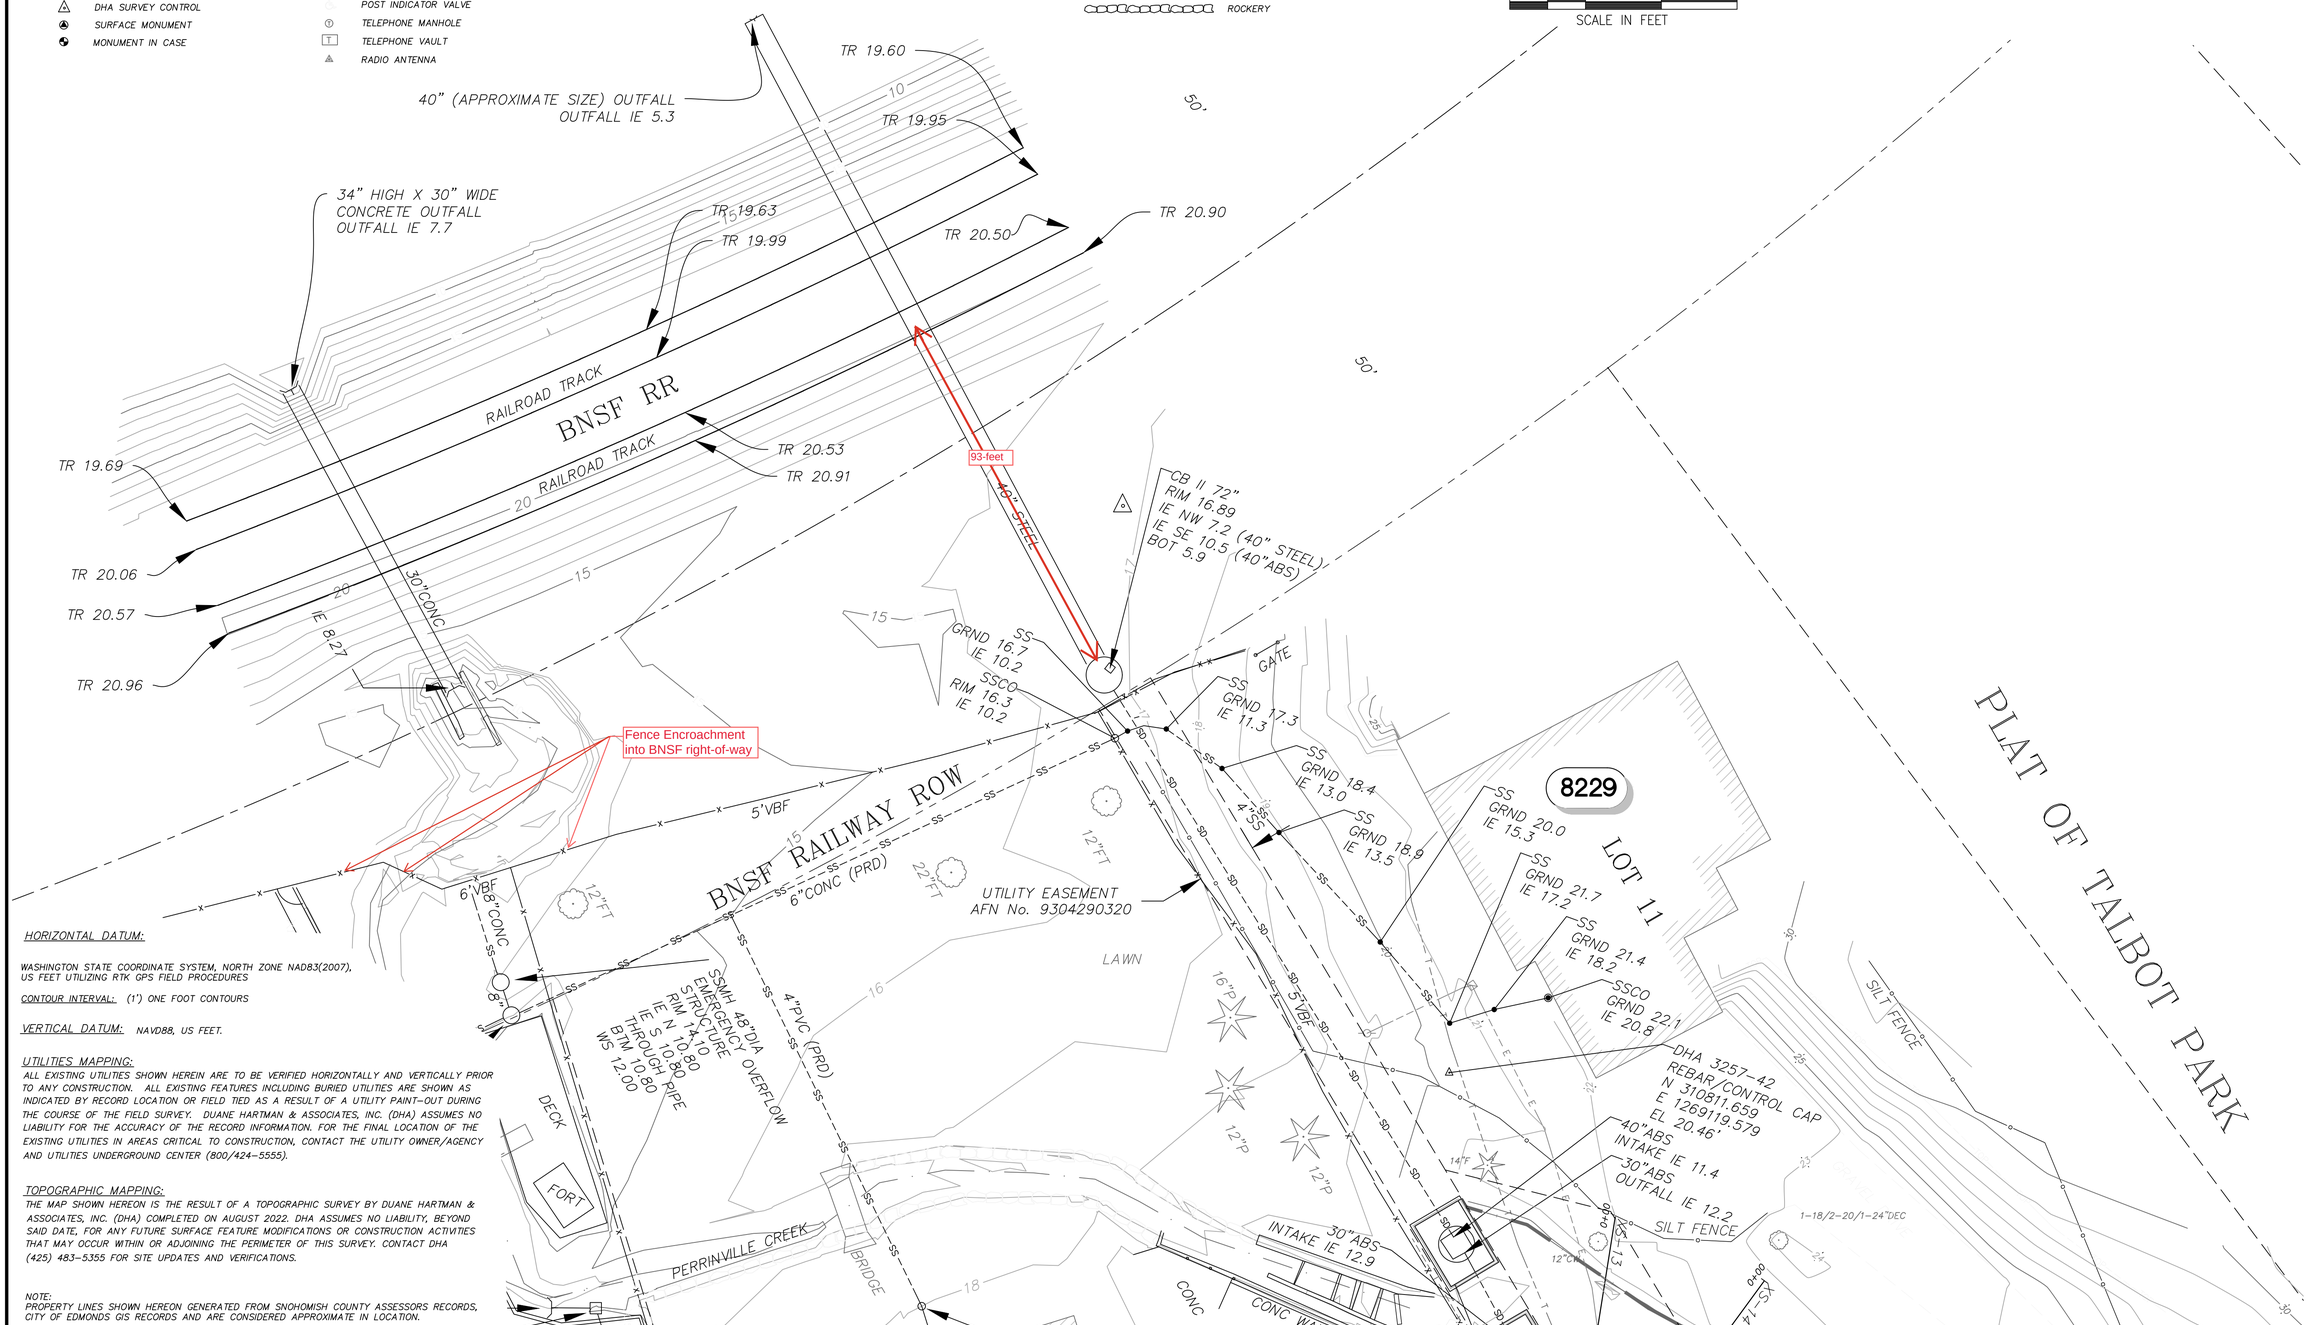

HORIZONTAL DATUM:

WASHINGTON STATE COORDINATE SYSTEM, NORTH ZONE NAD83(2007), US FEET UTILIZING RTK GPS FIELD PROCEDURES

CONTOUR INTERVAL: (1') ONE FOOT CONTOURS

VERTICAL DATUM: NAVD88, US FEET.

UTILITIES MAPPING:

ALL EXISTING UTILITIES SHOWN HEREIN ARE TO BE VERIFIED HORIZONTALLY AND VERTICALLY PRIOR TO ANY CONSTRUCTION. ALL EXISTING FEATURES INCLUDING BURIED UTILITIES ARE SHOWN AS INDICATED BY RECORD LOCATION OR FIELD TIED AS A RESULT OF A UTILITY PAINT-OUT DURING THE COURSE OF THE FIELD SURVEY. DUANE HARTMAN & ASSOCIATES, INC. (DHA) ASSUMES NO LIABILITY FOR THE ACCURACY OF THE RECORD INFORMATION. FOR THE FINAL LOCATION OF THE EXISTING UTILITIES IN AREAS CRITICAL TO CONSTRUCTION, CONTACT THE UTILITY OWNER/AGENCY AND UTILITIES UNDERGROUND CENTER (800/424-5555).

TOPOGRAPHIC MAPPING:

THE MAP SHOWN HEREON IS THE RESULT OF A TOPOGRAPHIC SURVEY BY DUANE HARTMAN & ASSOCIATES, INC. (DHA) COMPLETED ON AUGUST 2022. DHA ASSUMES NO LIABILITY, BEYOND SAID DATE, FOR ANY FUTURE SURFACE FEATURE MODIFICATIONS OR CONSTRUCTION ACTIVITIES THAT MAY OCCUR WITHIN OR ADJOINING THE PERIMETER OF THIS SURVEY. CONTACT DHA (425) 483-5355 FOR SITE UPDATES AND VERIFICATIONS.

NOTE:
PROPERTY LINES SHOWN HEREON GENERATED FROM SNOHOMISH COUNTY ASSESSORS RECORDS, CITY OF EDMONDS GIS RECORDS AND ARE CONSIDERED APPROXIMATE IN LOCATION.

NO.	DATE	BY	REVISION

	BY	DATE
DESIGN		
DRAWN	DAH	7-15-25
CHECKED	DAH	7-16-25
APPROVED		

APPROVED BY
ROBERT S. ENGLISH, P.E.
CITY ENGINEER
DATE

CITY OF EDMONDS
ENGINEERING DIVISION
121 5TH AVENUE NORTH
EDMONDS, WASHINGTON 98020
(425) 771-0220

PERRINVILLE CREEK SURVEY
EDMONDS, WASHINGTON
TOPOGRAPHIC SURVEY

H. SCALE 1" = 20'
V. SCALE

SHEET 1 OF 2 SHEETS

JOB NO. ----